




FLOOR PLANS

22801 Roscoe Boulevard

GET TO THE **POINTE.**

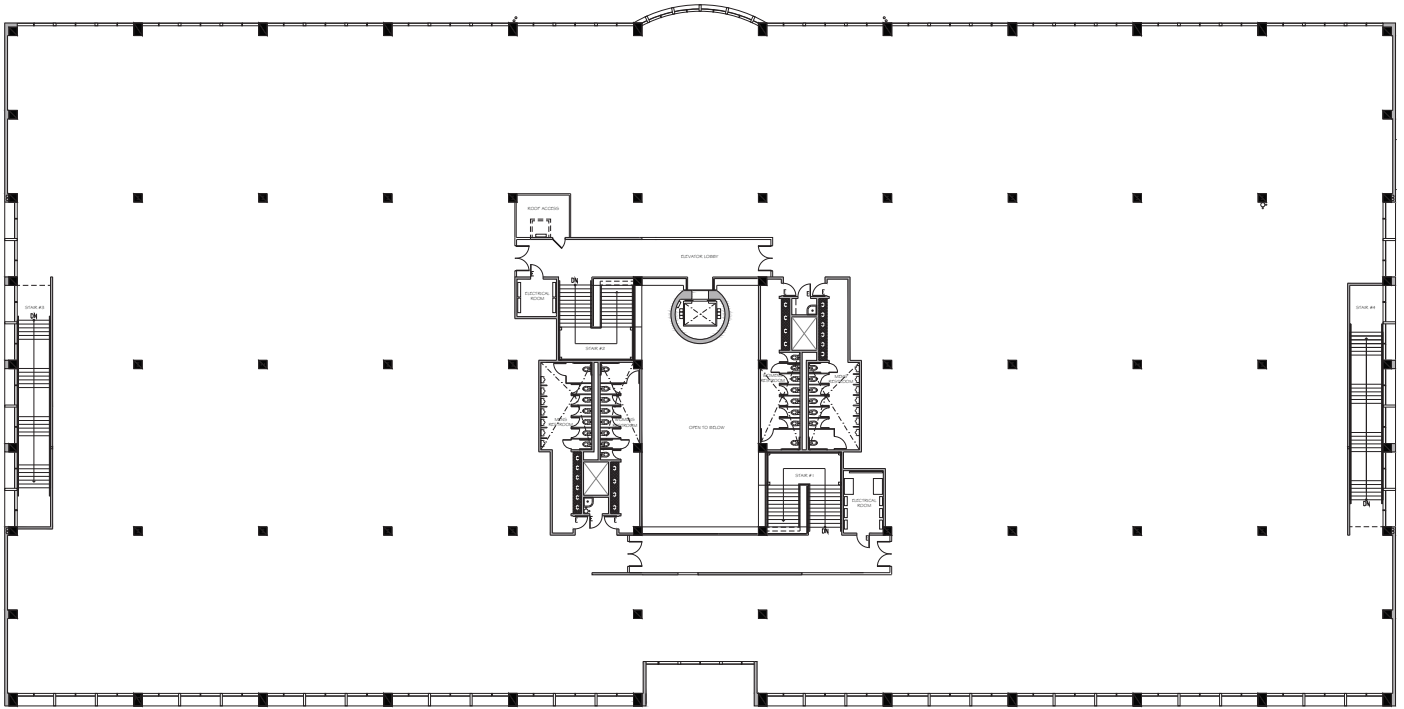

SIZE: ±51,655 RSF
22801 Roscoe Blvd
2nd Floor
As-Built Plan

CORPORATE POINTE at WEST HILLS

Brookfield | CBRE

© 2013 CBRE, Inc. This information has been obtained from sources believed reliable. We have not verified it and make no guarantee, warranty or representation about it. Any projections, opinions, assumptions or estimates used are for example only and do not represent the current or future performance of the property. You and your advisors should conduct a careful, independent investigation of the property to determine to your satisfaction the suitability of the property for your needs.